

PARTITION KEY


- CORE WALL
- DEMOLITION PARTITION
- EXISTING PARTITION
- NEW Variable Width PARTITION
- NEW 75mm PARTITION
- NEW 100mm PARTITION
- NEW 100mm SLAB TO SLAB PARTITION
- SILICON JOINTED GLAZING
- EXISTING SILICON JOINTED GLAZING
- DEMOLITION SILICON JOINTED GLAZING
- SILICON JOINTED DOUBLE GLAZING
- EXISTING SILICON JOINTED DOUBLE GLAZING
- DEMOLITION SILICON JOINTED DOUBLE GLAZING
- NEW DOUBLE GLAZED SYMBOL
- NEW SINGLE GLAZED SYMBOL

- FIRE RATED PARTITION
- PLY STRENGTHENING ADDED TO PARTITION
- SOUND BAFFLES ADDED ABOVE PARTITION

- FIRE RATED PARTITION REFERENCE
- FV - FLOOR VOID / CV - CEILING VOID

- SOUND BAFFLE REFERENCE
- FV - FLOOR VOID / CV - CEILING VOID

- PARTITIONING STRENGTHENING
- M - MDF / P - PLY

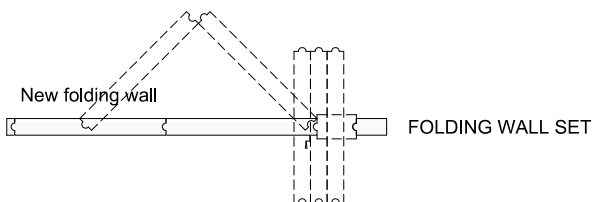

NOTES  
ALL NEW SKIRTING TO MATCH BASE BUILD SKIRTING IN HEIGHT AND PROFILE UNLESS OTHERWISE SHOWN

AB	AS BUILT	DH	04-02-20
REV	DESCRIPTION	DRWN	DATE

DRAWING STAGE

AS BUILT

CLIENT

BOULTBEE BROOKS

SITE ADDRESS

THE BRICKWORKS  
35 - 43 GREYFRIARS ROAD  
READING, RG1 1NP

CLIENT CONTACT

ACCOUNT MANAGER

MM

PROJECT DESIGNER

TECHNICAL DESIGNER

NW

DH

DRAWING TITLE

PROPOSED FIRST FLOOR  
GENERAL ARRANGEMENT

PROJECT NO.

1043

SCALE

1:50 @ A1

STATUS

AB

REVISION

AB

DRAWING NO.

1043 — 00 — 01 — GA — AB



Friary Court  
13-21 High Street  
Guildford, GU1 3DG  
020 7553 9500  
oktra.co.uk

AUTHORISATION

PRINT NAME

SIGNED

DATE / /

© COPYRIGHT OKTRA LTD

THIS DRAWING REMAINS THE COPYRIGHT OF OKTRA LTD, TO BE USED SOLELY FOR THE PROJECT AND INFORMATION AS TITLED. THIS DRAWING MUST NOT BE COPIED WITHOUT PRIOR WRITTEN CONSENT. CONTRACTORS ARE RESPONSIBLE FOR ENSURING ALL WORKS COMPLY WITH ALL RELEVANT STATUTORY REQUIREMENTS AND BRITISH STANDARDS.

DO NOT SCALE FROM DRAWING. CONTRACTORS MUST CHECK ALL DIMENSIONS, LEVELS AND SERVICES PRIOR TO COMMENCEMENT OF ANY WORKS. OKTRA LTD MUST BE NOTIFIED OF ANY DISCREPANCIES.

V:\PROJECTS\JUNE 2018 TO MAY 2019 PROJECT FILES\B\BOULTBEE BROOKS - THE BRICKWORKS 100911 - DESIGN\00 - CAD FILES