


NEW BREAKOUT FURNITURE TO BE SOURCED

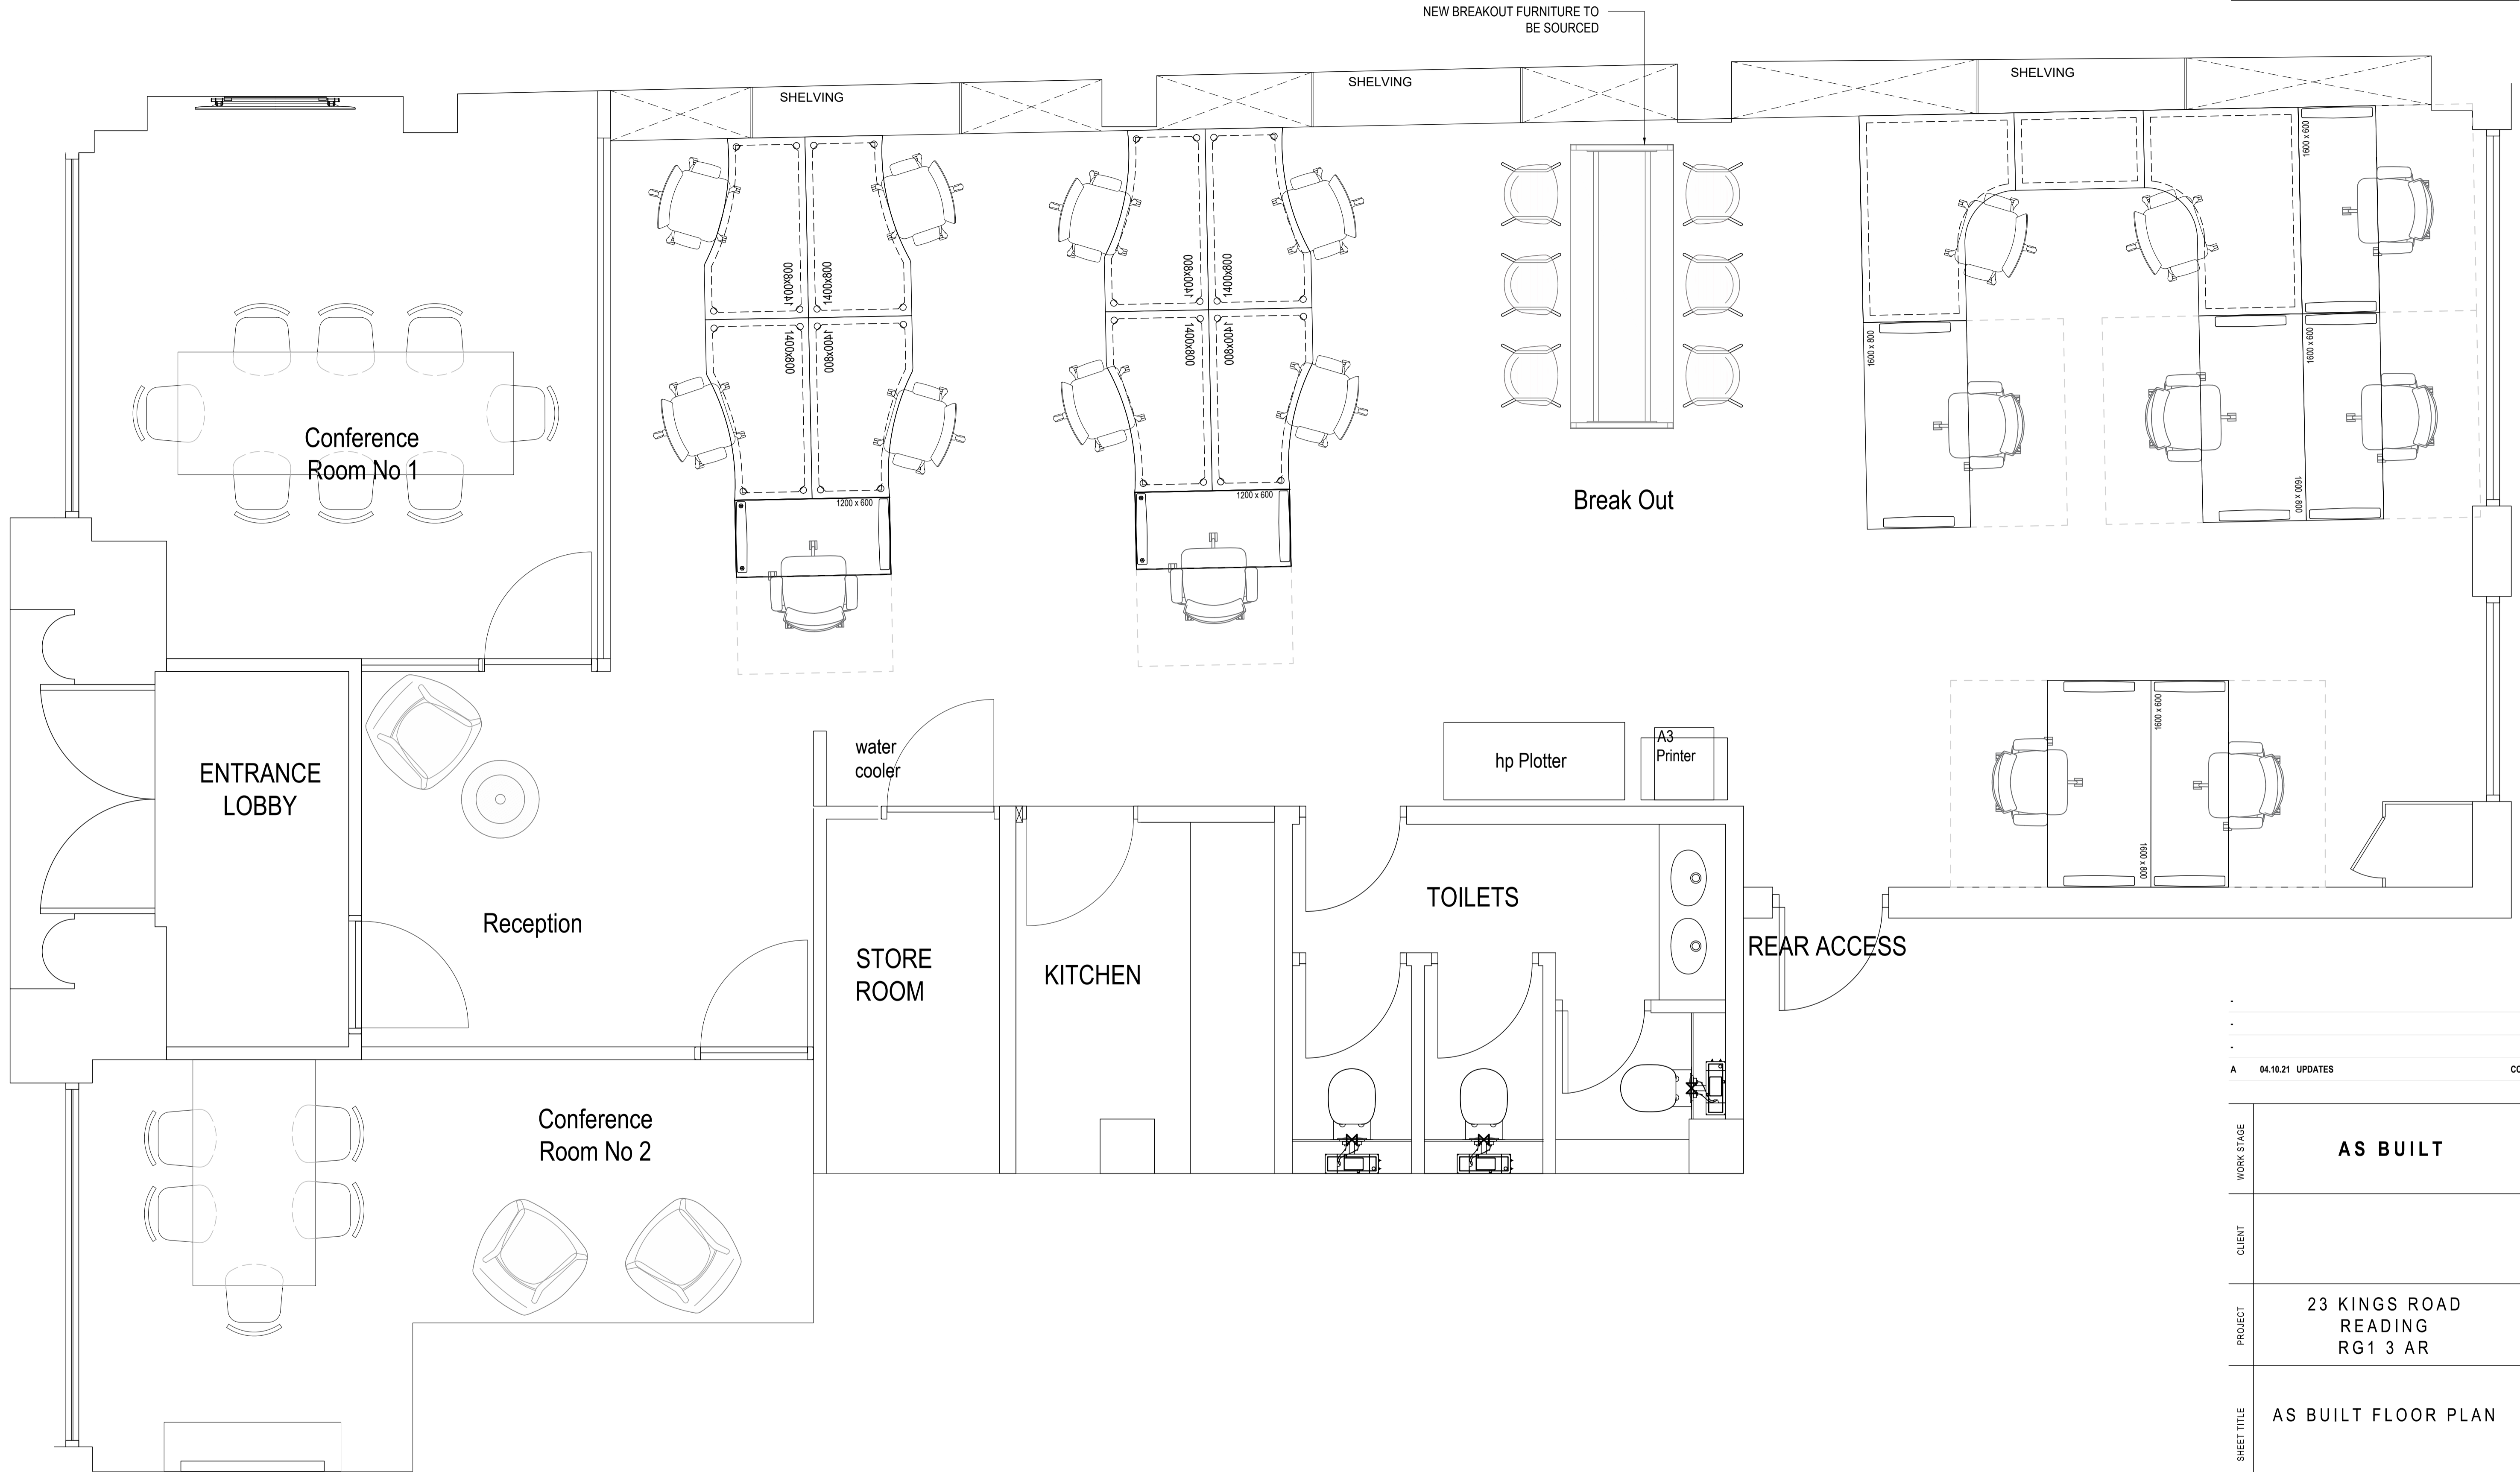

**PROPOSED PLAN**

SCALE 1:25

A 04.10.21 UPDATES CC

WORK STAGE	<b>AS BUILT</b>	
CLIENT		
PROJECT	23 KINGS ROAD READING RG1 3 AR	
SHEET TITLE	AS BUILT FLOOR PLAN	
SCALE	AS SHOWN AT A1	BY
SHEET NO.	J002143_A2_00	REVISION: C



QUADRANT DESIGN  
23 KINGS ROAD,  
READING,  
RG1 3AR  
73-74 BERWICK STREET,  
LONDON,  
W1F 8TE  
(+44)0118 9591 581  
hello@quadrantdesign.co.uk  
www.quadrantdesign.co.uk

INTERIORS | ARCHITECTURE | BRANDING